
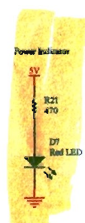
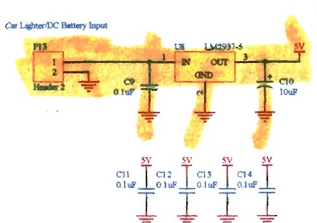
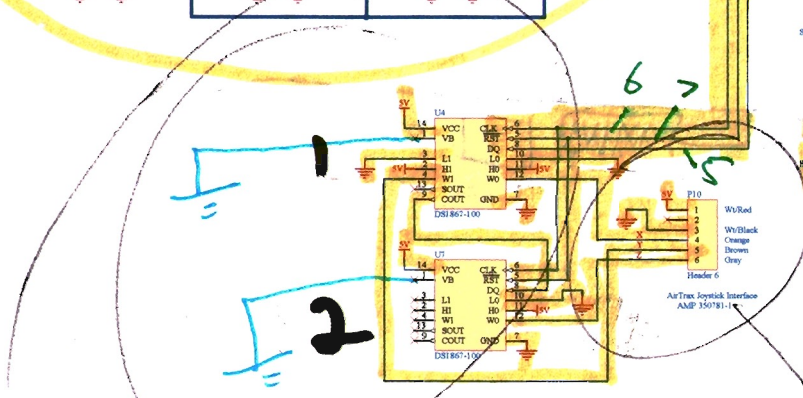


Prototype This: Traffic Buster Control Module


Rev: 1.0	Date: May 14, 2007	Drawn By: J. Grand	Rev: 1.0
----------	--------------------	--------------------	----------

NOT NEGOTIATED FOR TEST FRAME

~~Other~~ terminal connectors

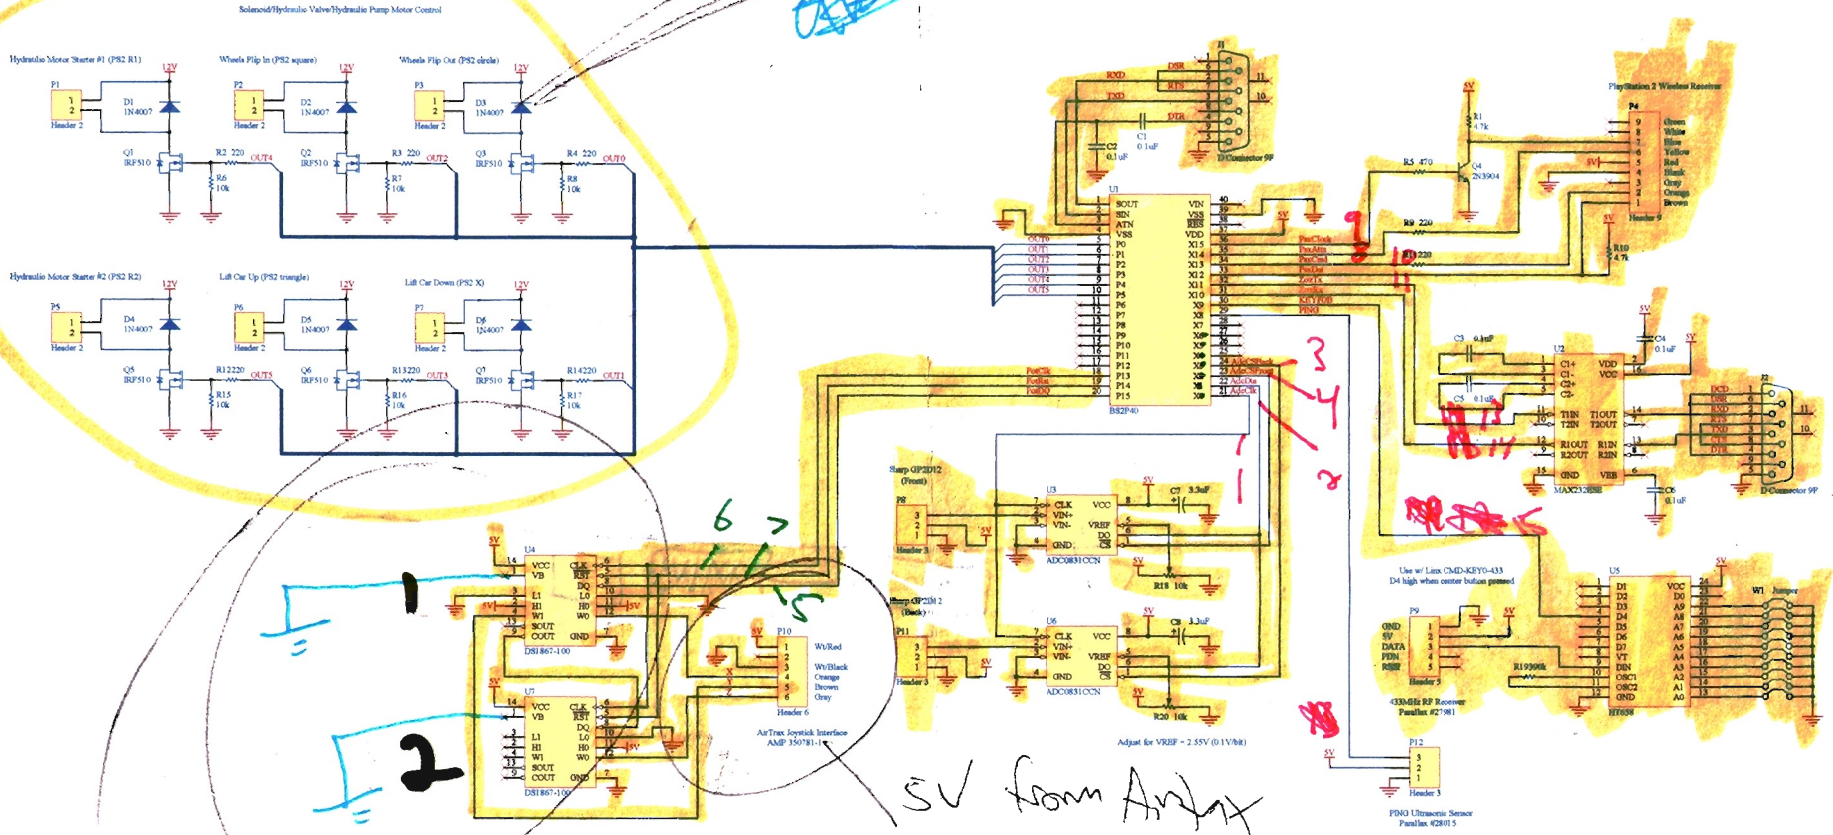



Prototype This! Episode 3: Traffic Busting Truck, Joe Grand's Engineering Development Notes, www.grandidea.com



Prototype This. Traffic Buster Control Module

Scale: 1:1

Author: J. Grand

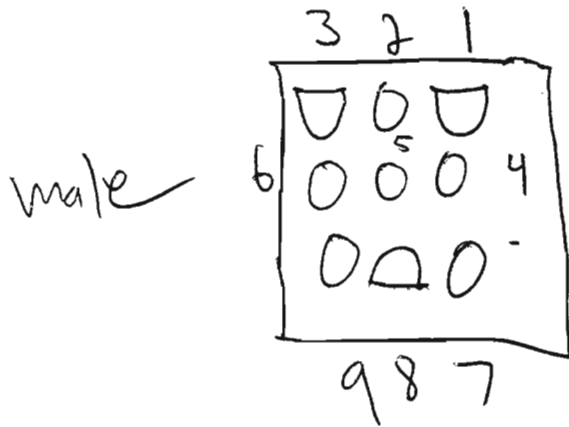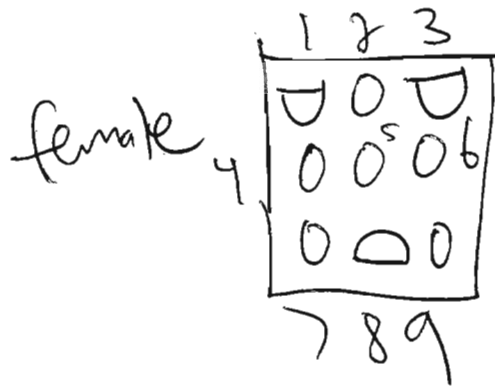

wire #	pin	Color	pin 5 no trace
28 ✓✓	1	white	pin 5 no trace
10 ✓✓	2	black	
8 ✓✓✓	3	red	
70 ✓✓✓	4	yellow (thick)	
37 ✓✓✓	5	unshielded/bare	
72 ✓✓✓	6	green	
x	7	x	
x	8	x	
35 ✓✓✓	9	green (thick)	

AIRTRAX SIGNAL/BUS CABLING 6/8/07

# AIRTRAX JOYSTICK CONTROL - RECEIVER

5/9/07


USING LOGITECH PS2 COAXIAL PRECISION # C-X2C31  
AS TRANSMITTER  
P/N# 863779-000

LEFT ANALOG JOYSTICK: X AXIS: TRACK LEFT/RIGHT  
Y AXIS: TRACK FORWARDS/BACKWARDS

RIGHT ANALOG JOYSTICK: X AXIS: ROTATE LEFT/RIGHT

- DIGITAL BUTTONS
- ④ □ WHEELS FLIP IN (small cylinders)
  - ① ○ WHEELS FLIP OUT (small cylinders)
  - ② △ LEFT CAR UP (big cylinders)
  - ③ X LEFT CAR DOWN (big cylinders)
  - P1, P2 STARTER FOR HYDRAULIC MOTORS



SEE ALTIUM SCHEMATIC/PWB FOR FINAL DESIGN

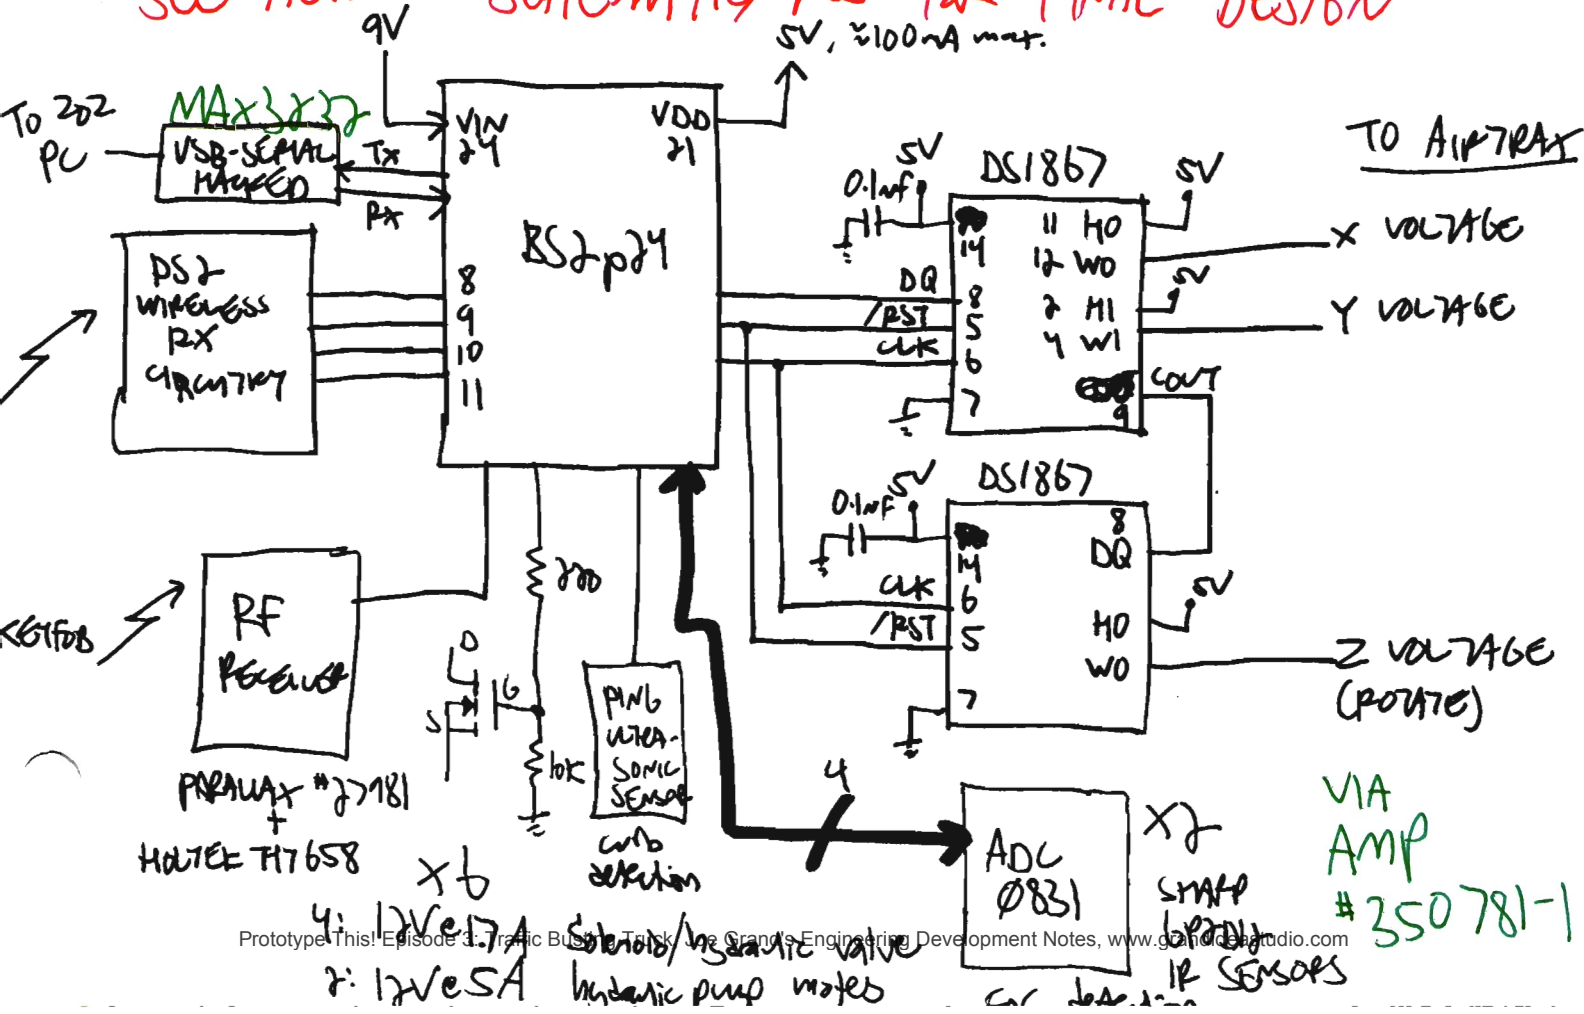

6: 12V SA Solenoid/hydraulic valve  
7: 12V SA hydraulic pump motor  
X2: STAMP BOARD  
Y: 12V SA Solenoid/hydraulic valve  
Z: 12V SA Solenoid/hydraulic valve  
4: 4V  
VIA AMP #350781-1  
IP SENSORS

5/7/07

# SENSOR TEST CIRCUITRY - SUPER-DUPER TRUCK 2020

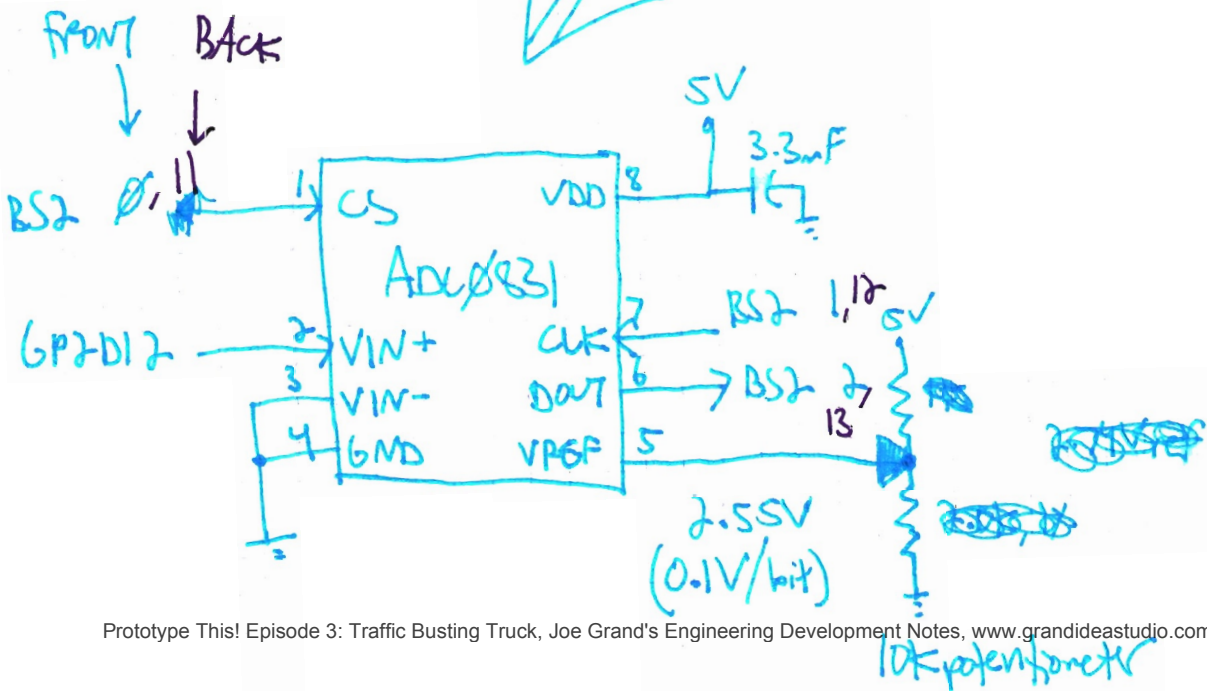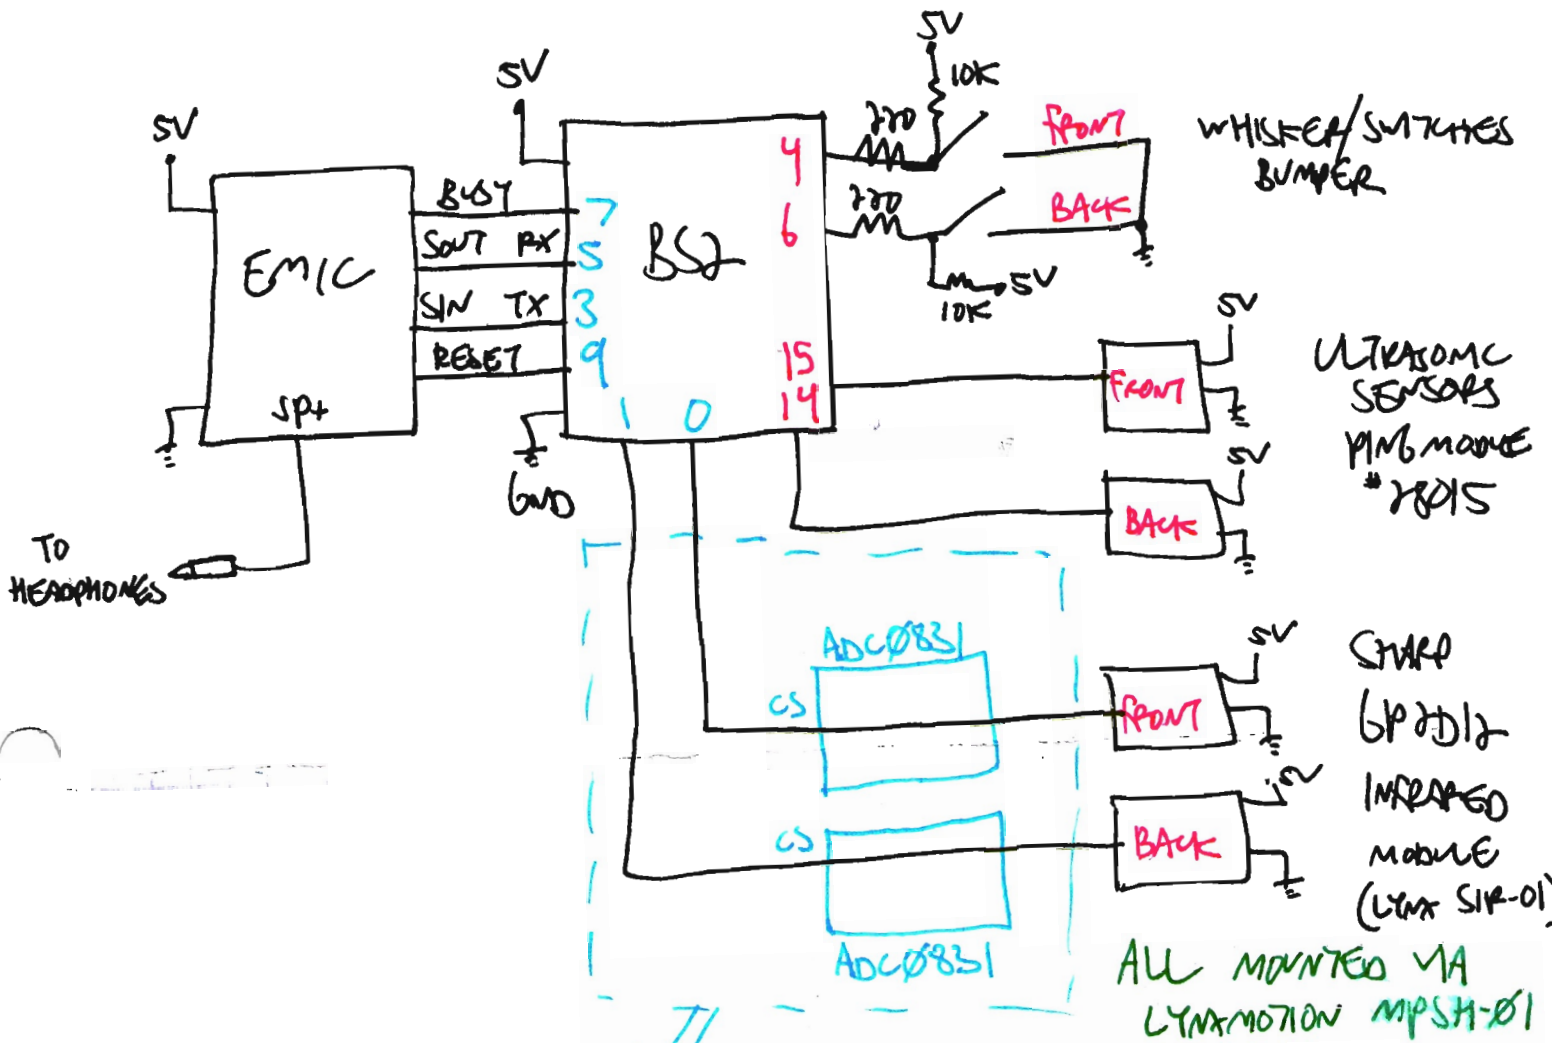

# AIRTRAX CONTROL INTERFACE

5/9/07

2 connectors! 1) 6-pin (2x3) joystick → input power 12V  
→ 3 and 4 males center  
female  
need extra

0-5V

2.5V  
ground

2) 5-pin (single - button/trigger

↑  
not needed for drive

0.5V - 4.5V  
will shut down if outside  
of that range

256

86 steps / ~~100~~ <sup>around</sup> in each axis  
deadband 2.5V

86 + 84 + 86


Each ~~axis~~ done inside  
- control unit CAN  
power

Dead recovery - x, y, z 2 minutes | 7 times  
sm return within 1cm  
on flat surface

# AIRTRAX JOYSTICK CONTROL HACK

S/7/07

## INITIAL BLOCK DIAGRAM

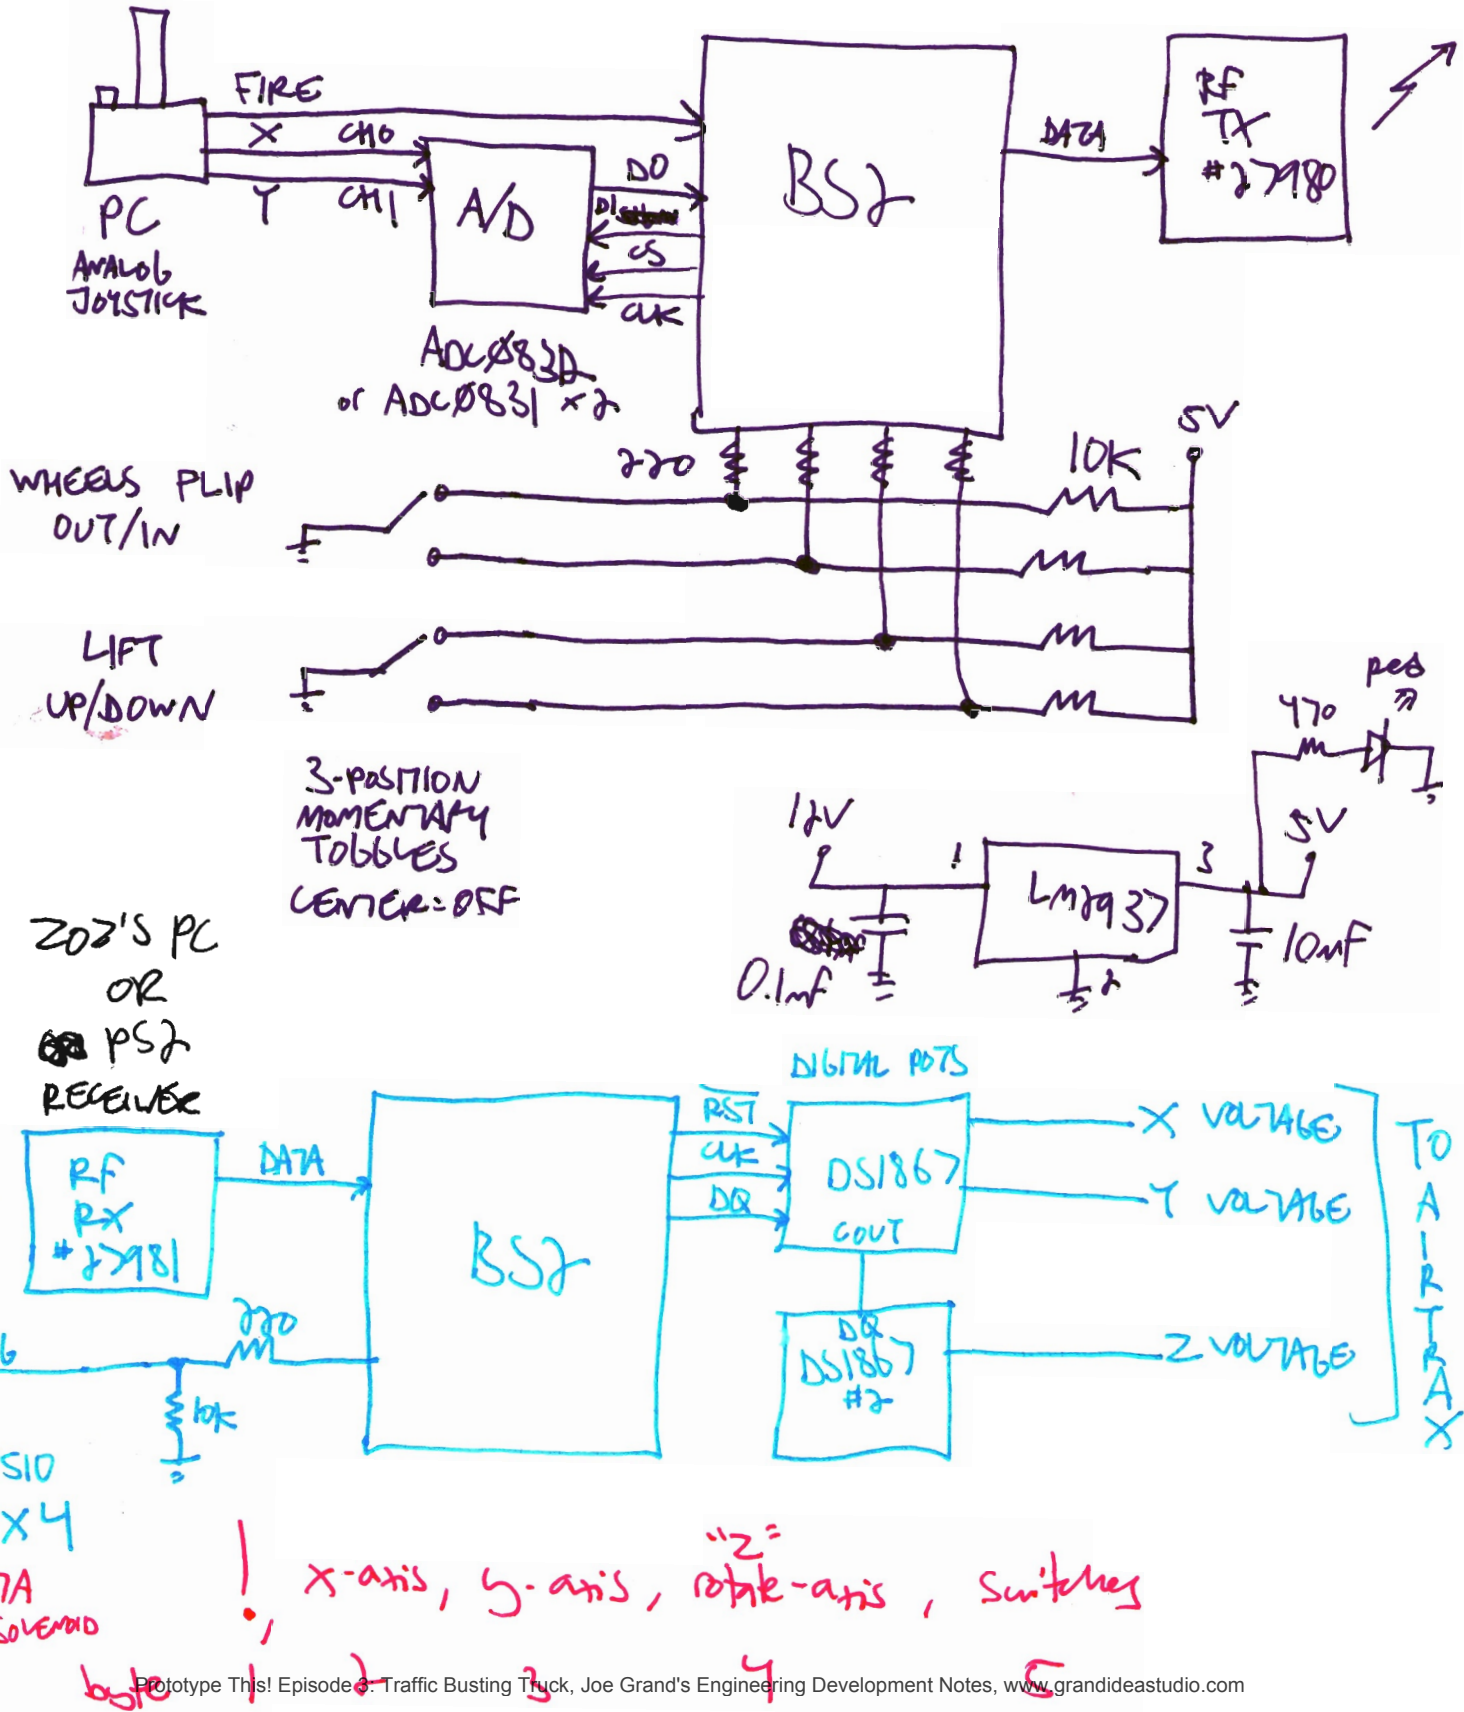

2V 1.7A  
MICRO SOLENOID  
VALVE

byte

4/3/07

# AIRTRAX CONTROL SYSTEM

- Open-loop analog control - joysticks
- 3 AXIS → 0-5V analog 288 steps  
or CAN-interface for longer-distance  
away controls
- closed-loop motor control system w/  
quadrature encoder per wheel - communicates w/  
BMC master/control module

3 MPH, 7-10k pounds - 17" wheel motor

GROUND, ST120, +48, CAN H, CAN L

\* 48V  
 \* harness connector for control } Connect to each  
 wheel motor

48V DC (50% - 75% deep cycle) 200A maximum  
 SOA peak draw/wheel  
 4 x 12V  
 8 x 6V 5-10A typical per  
 wheel